


Approved 4/8/08
 Scott Russell Vice Chair
 Signed 7/8/08



US Route 202
 Peterborough St.
 PAVED DRIVE

[238-312] RARED JAFFREY, LLC
 P.O. BOX 3165
 HARRISBURG, PA 17105
 BOOK 1717 PAGE 52

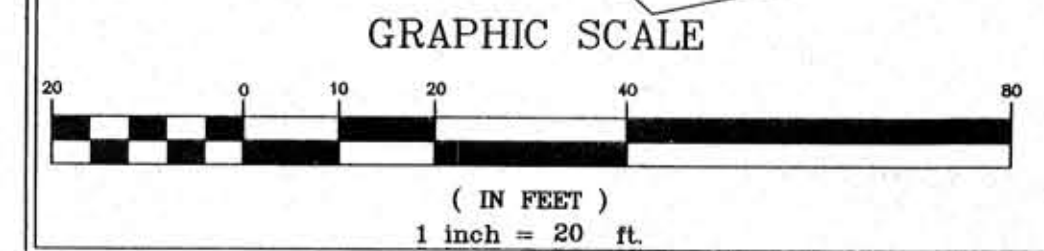

[238-302] MONADNOCK PROPERTIES, INC.
 724 ABBOTT HILL ROAD
 WILTON, NH 03086
 BOOK 1896 PAGE 622

RIVERMILL AT BASCOM FALLS, A CONDOMINIUM
 LAND OF
EASTMILL DEVELOPMENT, LLC
 BOOK 2405, PAGE 19, TRACT I
 Tax map 238 Lot 257-2
 8 Main Street, Jaffrey, Cheshire County, New Hampshire

SVE Associates © 2008
 Engineering Surveying Landscape Architecture Planning
 47 Marlboro St., Keene, NH 03431 Phone (603) 355-1532
 Fax (603) 355-2969 website: www.sveassoc.com

DATE PLAN:	7/7/08	PROJ. NO.:	K1711
DATE SURVEY:	11/07	CAD NO.:	K1711 ASBUILT
DESIGNED BY:	N/A	SHEET	2
DRAWN BY:	RLF	OF	2
CHECKED BY:	RJH		
SCALE:	1"=20'		

[238-297] WILLIAM F. GLIMENAKIS ET.AL.
 225 HELENA ST.
 LEOMINSTER, MA 01453
 BOOK 1272 PAGE 814

[238-301] JOHN C. MCGURTY
 PO BOX 543
 ANTRIM, NH 03440
 BOOK 1487 PAGE 734

[238-259] EASTMILL DEVELOPMENT, LLC
 P.O. BOX 58
 JAFFREY, NH 03458
 2405/19 TRACT II
 AREA
 0.19 ACRES± (8,165 SQ.FT.±)

[238-258] EAST JAFFREY TRUST
 14A ELLIOT STREET
 CAMBRIDGE, MA 02138
 1169/544

[238-257.2] EASTMILL DEVELOPMENT, LLC
 P.O. BOX 58
 JAFFREY, NH 03458
 2405/19

[238-257.1] GREAT BRIDGE MONADNOCK CONDOMINIUM
 CONDOMINIUM DECLARATION: 2405/29
 GREAT BRIDGE JAFFREY LIMITED PARTNERSHIP
 814 ELM ST., SUITE 400
 MANCHESTER, NH 03101
 2405/15

[238-5] PLH-MAN STREET, LLC
 P.O. BOX 768
 JAFFREY, NH 03458
 1857/304

[238-281] DOROTHY A. COLDEN
 25 PETERBOROUGH STREET
 JAFFREY, NH 03452
 1533/733